

## Existing




62 Spaces, Inc 21 Disabled Spaces and 2 Parent and Child Spaces.

## Existing Overlay onto Proposed



### NOTES

- Contractors must check all dimensions on site. Only figured dimensions are to be worked from. Discrepancies must be reported to the Architect or Engineer before proceeding. © This drawing is copyright.
- Reproduced from OS Sitemap © by permission of Ordnance Survey on behalf of The Controller of Her Majesty's Stationery Office. © Crown copyright 2008. All rights reserved. Licence number 100007126.
- Direct scaling off the drawing is permissible for planning purposes only.

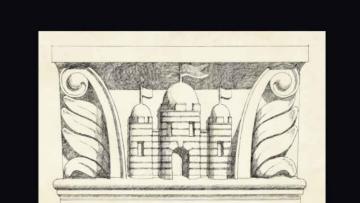

Old Town  
Newbury

## Proposed



Proposed M.S.C.P has 11 more Parking spaces, and retail stores have been replaced with a community cycle store with a capacity of 197 bikes.

73 Parking Spaces,  
Inc :  
55 Regular Spaces,  
18 Disabled Spaces.

REV	DESCRIPTION	DRN	CHD	DATE
	PRELIMINARY			INFORMATION
	CONSTRUCTION			TENDER

SCALE 1:200 @ A0 DATE AUG 2024

DRAWN TNM CHK JAL

DRAWING NO. 19401/1041 REV -

TITLE Old Town, Newbury.

DETAILS Ground Floor Plan, Multi Storey Car Park Comparison.

**LOCHAILORT**

Woods Hardwick  
Architecture | Engineering | Planning | Surveying

BEDFORD : HEAD OFFICE  
15-17 Goldring Road  
Bedford MK40 3NH  
T: +44 (0) 1234 268862

BIRMINGHAM  
Fort Dunlop, Fort Parkway  
Birmingham B24 9FE  
T: +44 (0) 121 6297784

ONLINE: mail@woodshardwick.com | woodshardwick.com

PLEASE CONSIDER THE ENVIRONMENT BEFORE PRINTING THIS DRAWING

## Existing



85 Parking Spaces.

## Existing Overlay onto Proposed



Proposed M.S.C.P has 16 more Parking spaces.


## Proposed



101 Parking Spaces,  
Inc :  
100 Regular Spaces,  
1 Extra Wide Space.

NOTES

- Contractors must check all dimensions on site. Only figured dimensions are to be worked from. Discrepancies must be reported to the Architect or Engineer before proceeding. © This drawing is copyright.
- Reproduced from OS Sitemap © by permission of Ordnance Survey on behalf of The Controller of Her Majesty's Stationery Office. © Crown copyright 2008. All rights reserved. Licence number 100007126.
- Direct scaling off the drawing is permissible for planning purposes only.

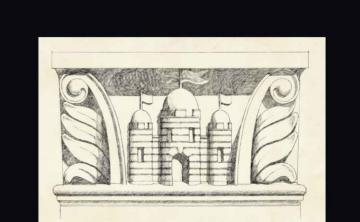

Old Town  
Newbury

REV	DESCRIPTION	DRN	CHD	DATE
	■ PRELIMINARY	□ INFORMATION	□ TENDER	
	□ CONSTRUCTION	□ AS BUILT		
SCALE	1:200 @ A0			DATE AUG 2024
DRAWN	TNM	CHK	JAL	
DRAWING NO.	19401/1042	REV		
TITLE	Old Town, Newbury.			
DETAILS	First Floor Plan, Multi Storey Car Park Comparison.			

**LOCHAILORT**

 Woods Hardwick  
Architecture | Engineering | Planning | Surveying

BEDFORD : HEAD OFFICE  
15-17 Goldington Road  
Bedford MK40 3NH  
T: +44 (0) 1234 268862

BIRMINGHAM  
Fort Dunlop, Fort Parkway  
Birmingham B24 9FE  
T: +44 (0) 121 6297784

ONLINE: mail@woodshardwick.com | woodshardwick.com

PLEASE CONSIDER THE ENVIRONMENT BEFORE PRINTING THIS DRAWING

# Existing




164 Parking Spaces, Inc 66 Spaces Outside.

# Existing Overlay onto Proposed



## NOTES

- Contractors must check all dimensions on site. Only figured dimensions are to be worked from. Discrepancies must be reported to the Architect or Engineer before proceeding. © This drawing is copyright.
- Reproduced from OS Sitemap © by permission of Ordnance Survey on behalf of The Controller of Her Majesty's Stationery Office. © Crown copyright 2008. All rights reserved. Licence number 100007126.
- Direct scaling off the drawing is permissible for planning purposes only.

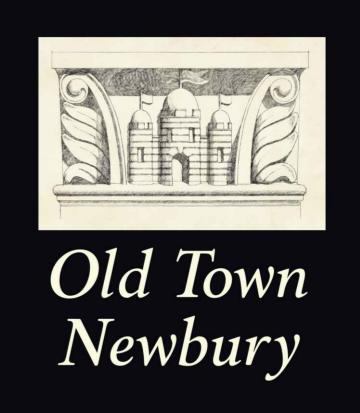

# Proposed



Proposed M.S.C.P has 63 Less Parking spaces.

101 Parking Spaces,  
Inc :  
100 Regular Spaces,  
1 Extra Wide Space.

REV	DESCRIPTION	DRN	CHD	DATE
	PRELIMINARY			INFORMATION
	CONSTRUCTION			AS BUILT
SCALE	1:200 @ A0			DATE AUG 2024
DRAWN	TNM		CHK	JAL
DRAWING NO.	19401/1043		REV	-
TITLE	Old Town, Newbury.			
DETAILS	Second Floor Plan, Multi Storey Car Park Comparison.			

**LOCHAILORT**


 Woods Hardwick  
Architecture | Engineering | Planning | Surveying

BEDFORD : HEAD OFFICE  
15-17 Goldington Road  
Bedford MK40 3NH  
T: +44 (0) 1234 268862  
BIRMINGHAM  
Fort Dunlop, Fort Parkway  
Birmingham B24 9FE  
T: +44 (0) 121 6297784


ONLINE: mail@woodshardwick.com | woodshardwick.com

PLEASE CONSIDER THE ENVIRONMENT BEFORE PRINTING THIS DRAWING

# Existing

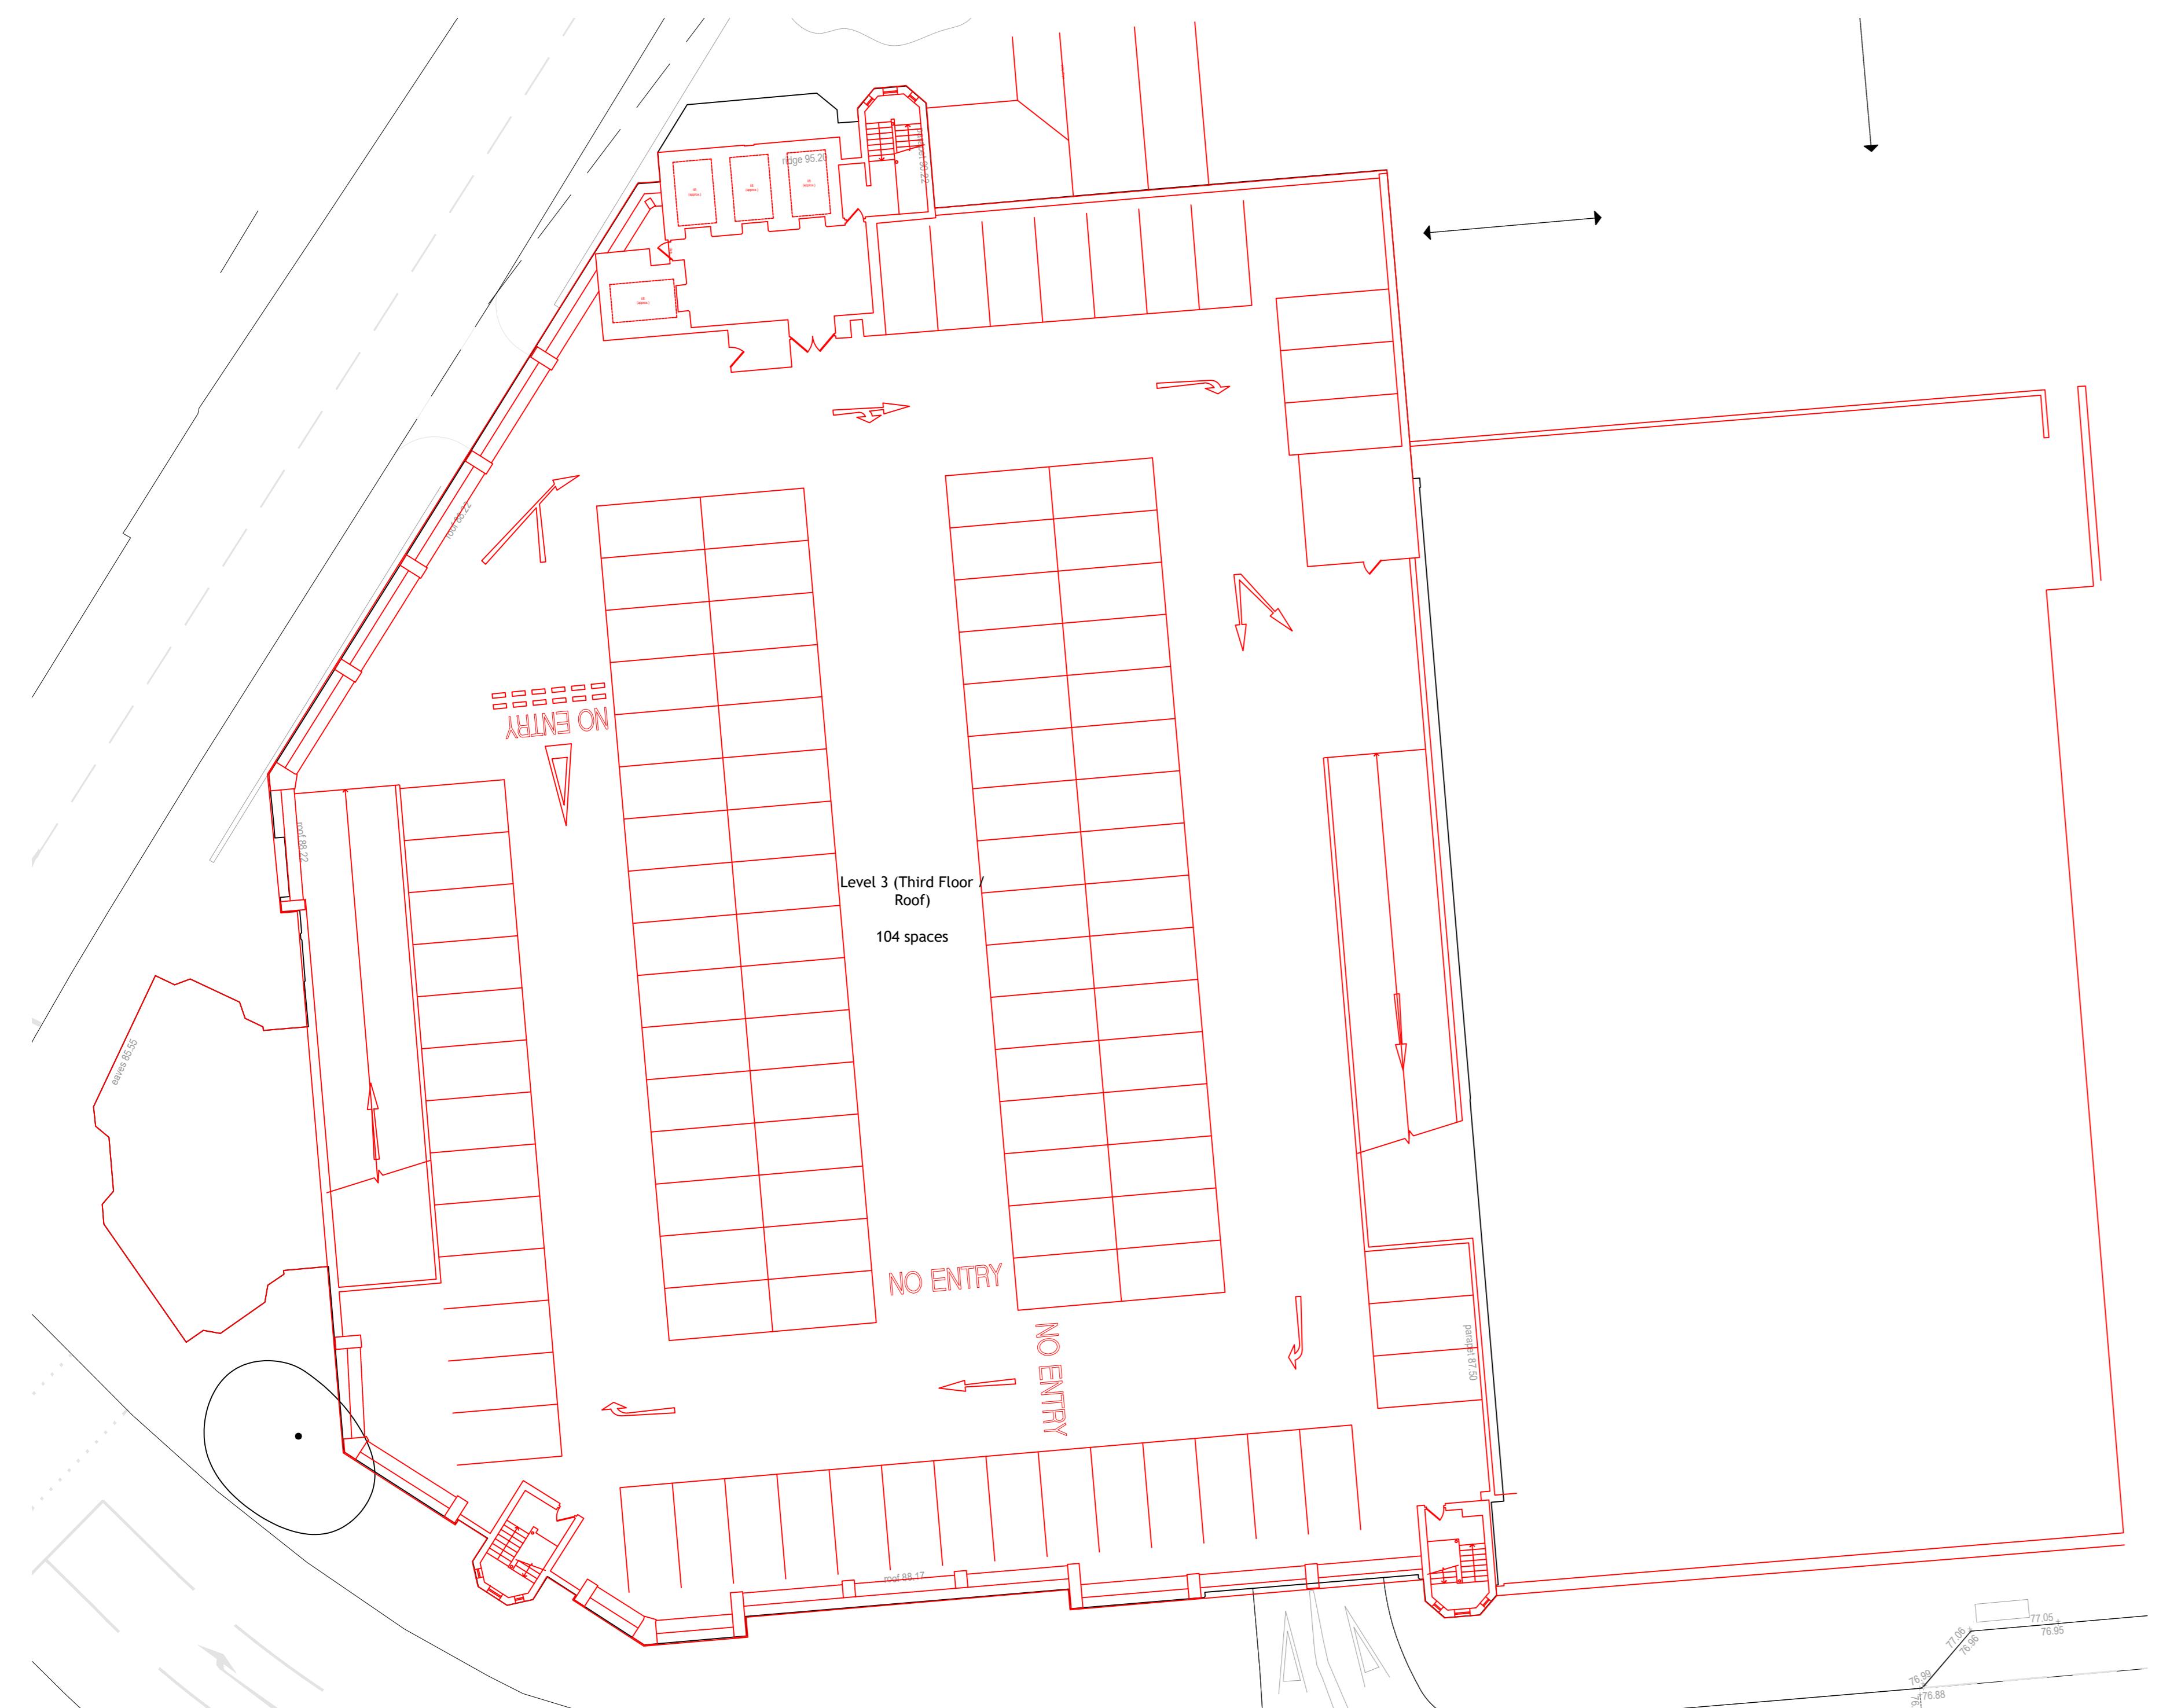

# Existing Overlay onto Proposed

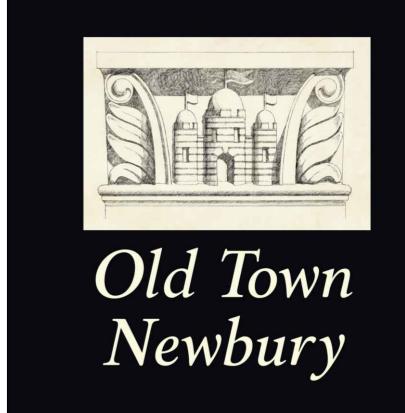

## NOTES

1. Contractors must check all dimensions on site. Only figured dimensions are to be worked from. Discrepancies must be reported to the Architect or Engineer before proceeding. © This drawing is copyright.
2. Reproduced from OS Sitemap © by permission of Ordnance Survey on behalf of The Controller of Her Majesty's Stationery Office. © Crown copyright 2008. All rights reserved. Licence number 100007126.
3. Direct scaling off the drawing is permissible for planning purposes only.

# Proposed



Proposed M.S.C.P has 3 Less Parking spaces.

101 Parking Spaces,  
Inc :  
100 Regular Spaces,  
1 Extra Wide Space.

REV	DESCRIPTION	DRN	CHD	DATE
	PRELIMINARY			INFORMATION
	CONSTRUCTION			TENDER
				AS BUILT
SCALE	1:200 @ A0			DATE AUG 2024
DRAWN	TNM		CHK	JAL
DRAWING NO.	19401/1044		REV	-
TITLE	Old Town, Newbury.			
DETAILS	Third Floor Plan, Multi Storey Car Park Comparison.			

**LOCHAILORT**

 Woods Hardwick  
Architecture | Engineering | Planning | Surveying


BEDFORD : HEAD OFFICE  
15-17 Goldington Road  
Bedford MK40 3NH  
T: +44 (0) 1234 268862

BIRMINGHAM  
Fort Dunlop, Fort Parkway  
Birmingham B24 9FE  
T: +44 (0) 121 6297784

ONLINE: mail@woodshardwick.com | woodshardwick.com

PLEASE CONSIDER THE ENVIRONMENT BEFORE PRINTING THIS DRAWING

## Proposed Additional Fourth Floor to the M.S.C.P

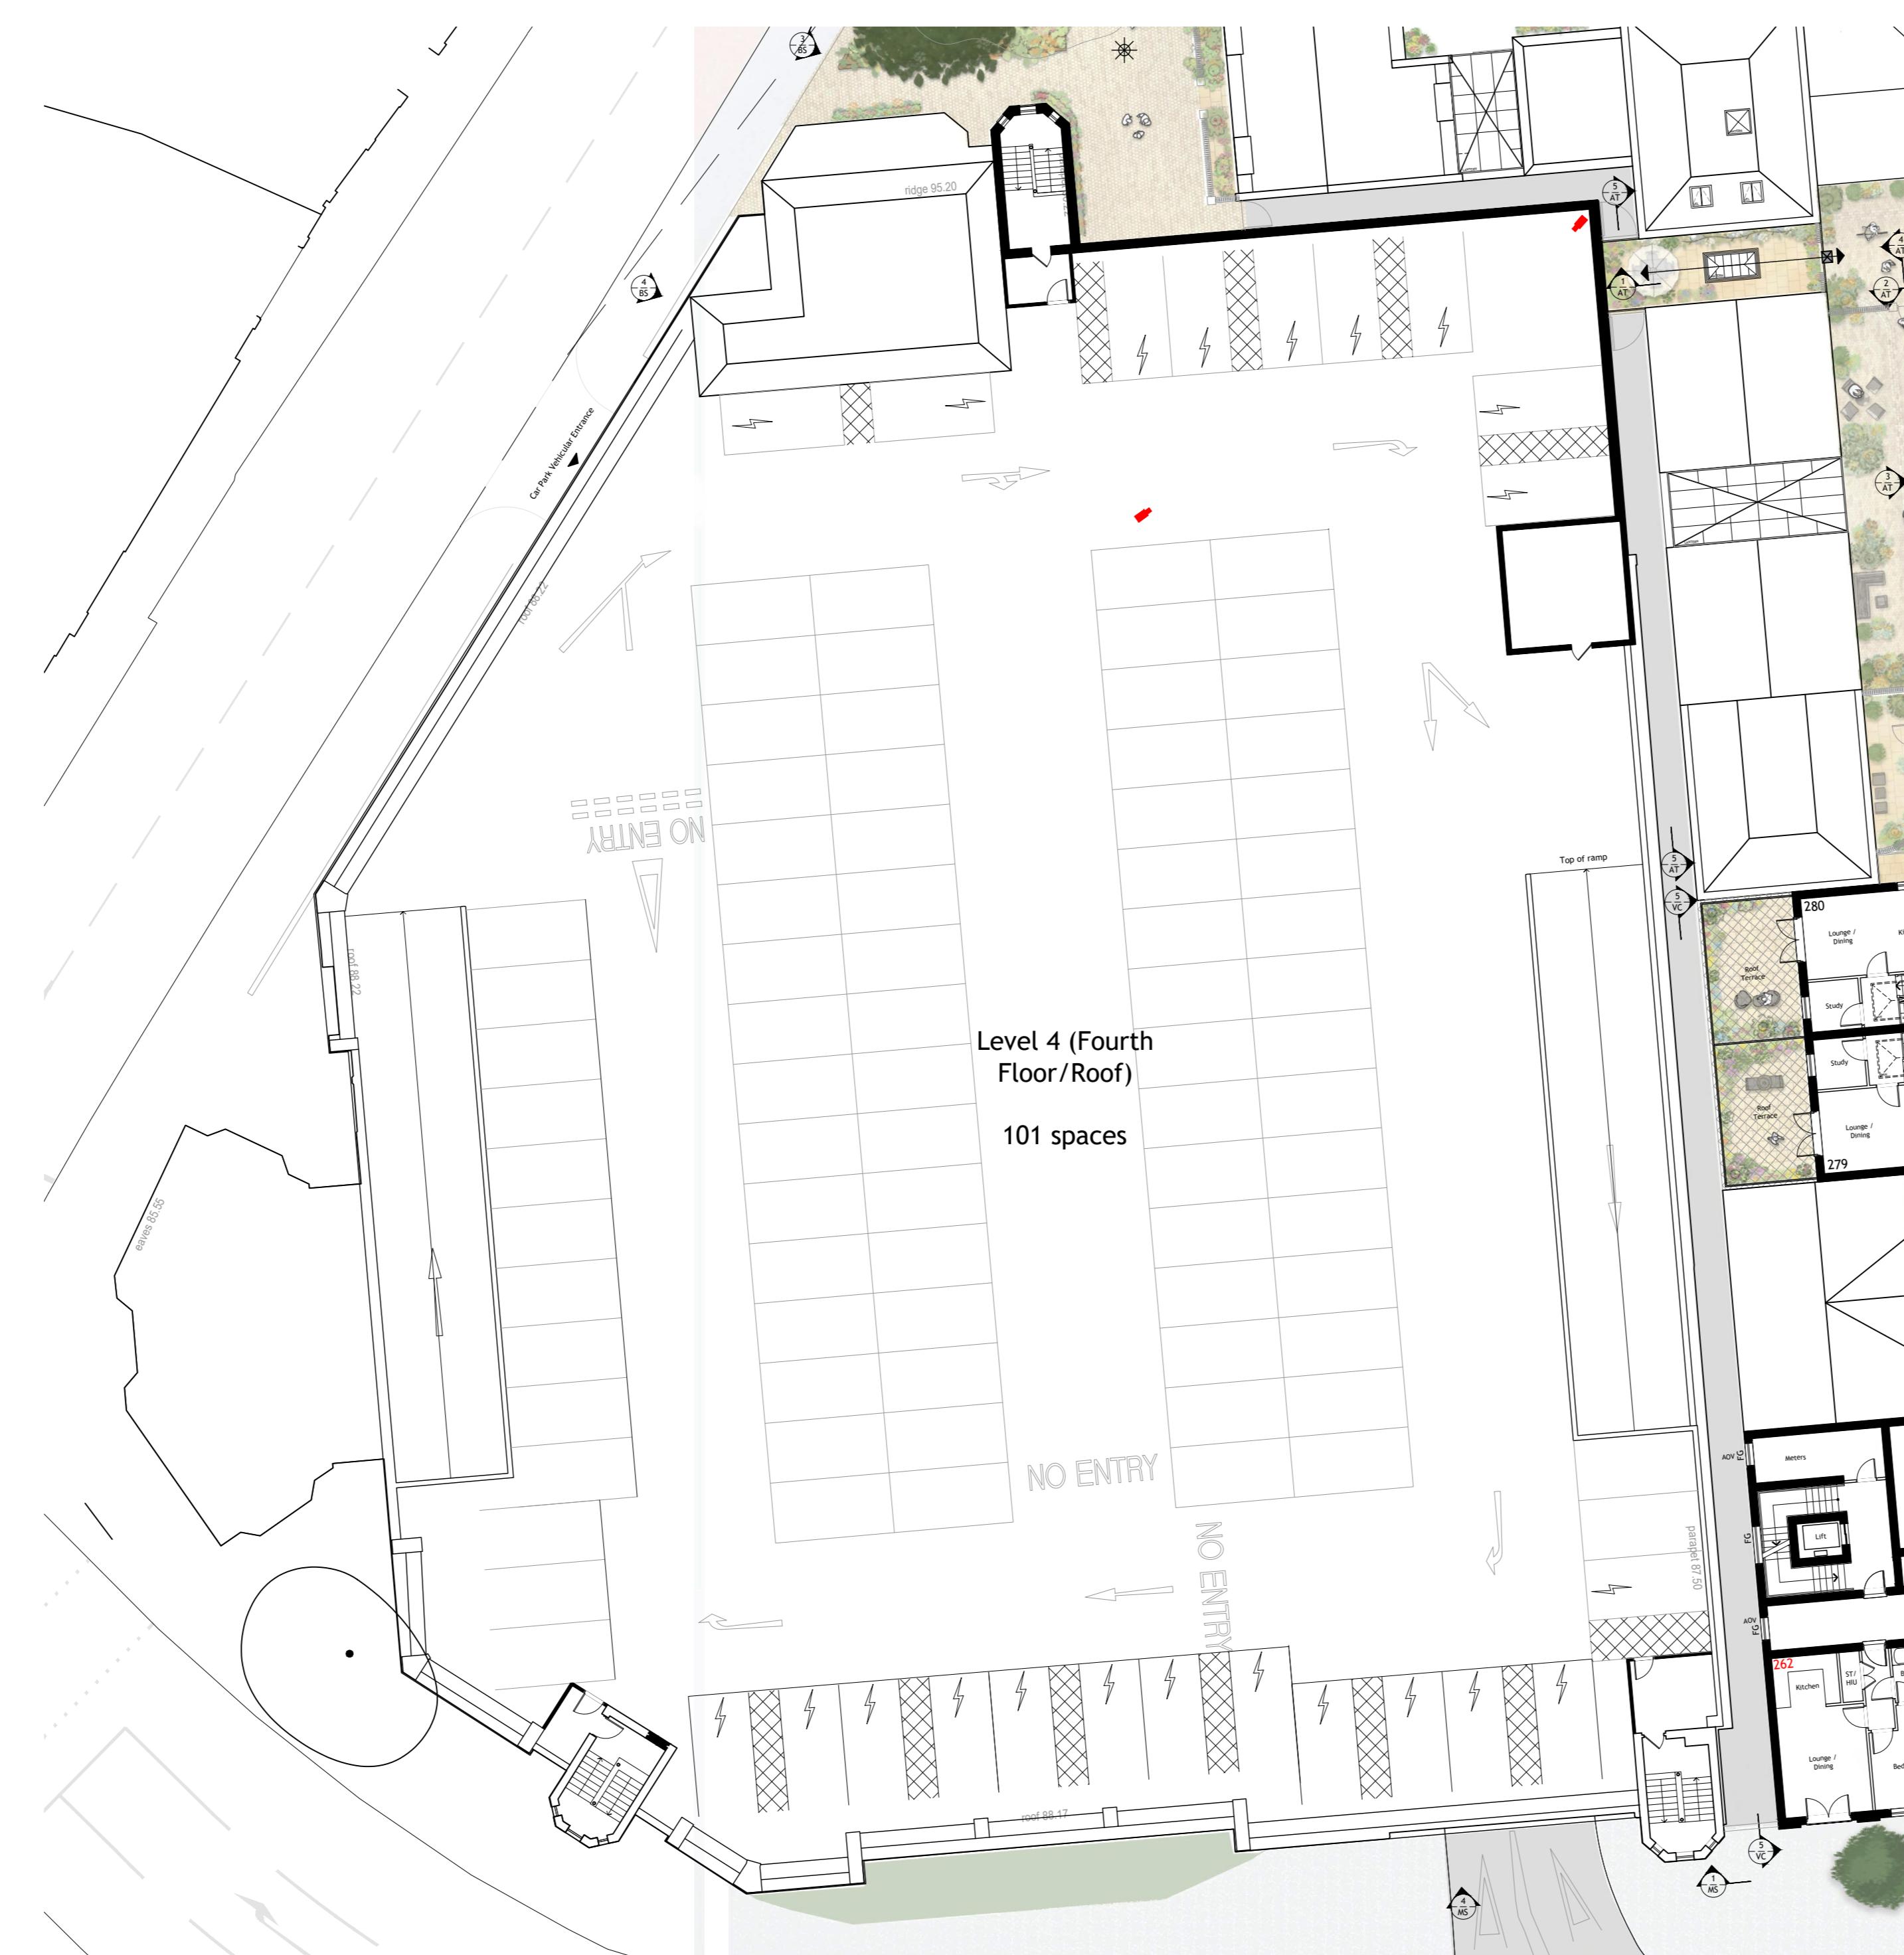


101 Parking Spaces,  
Inc :  
80 Regular Spaces.  
17 EV Charging Spaces  
3 Car Club/EV  
1 Car Club

NOTES

- Contractors must check all dimensions on site. Only figured dimensions are to be worked from. Discrepancies must be reported to the Architect or Engineer before proceeding. © This drawing is copyright.
- Reproduced from OS Sitemap © by permission of Ordnance Survey on behalf of The Controller of Her Majesty's Stationery Office. © Crown copyright 2008. All rights reserved. Licence number 100007126.
- Direct scaling off the drawing is permissible for planning purposes only.

## Proposed Elevation for the M.S.C.P

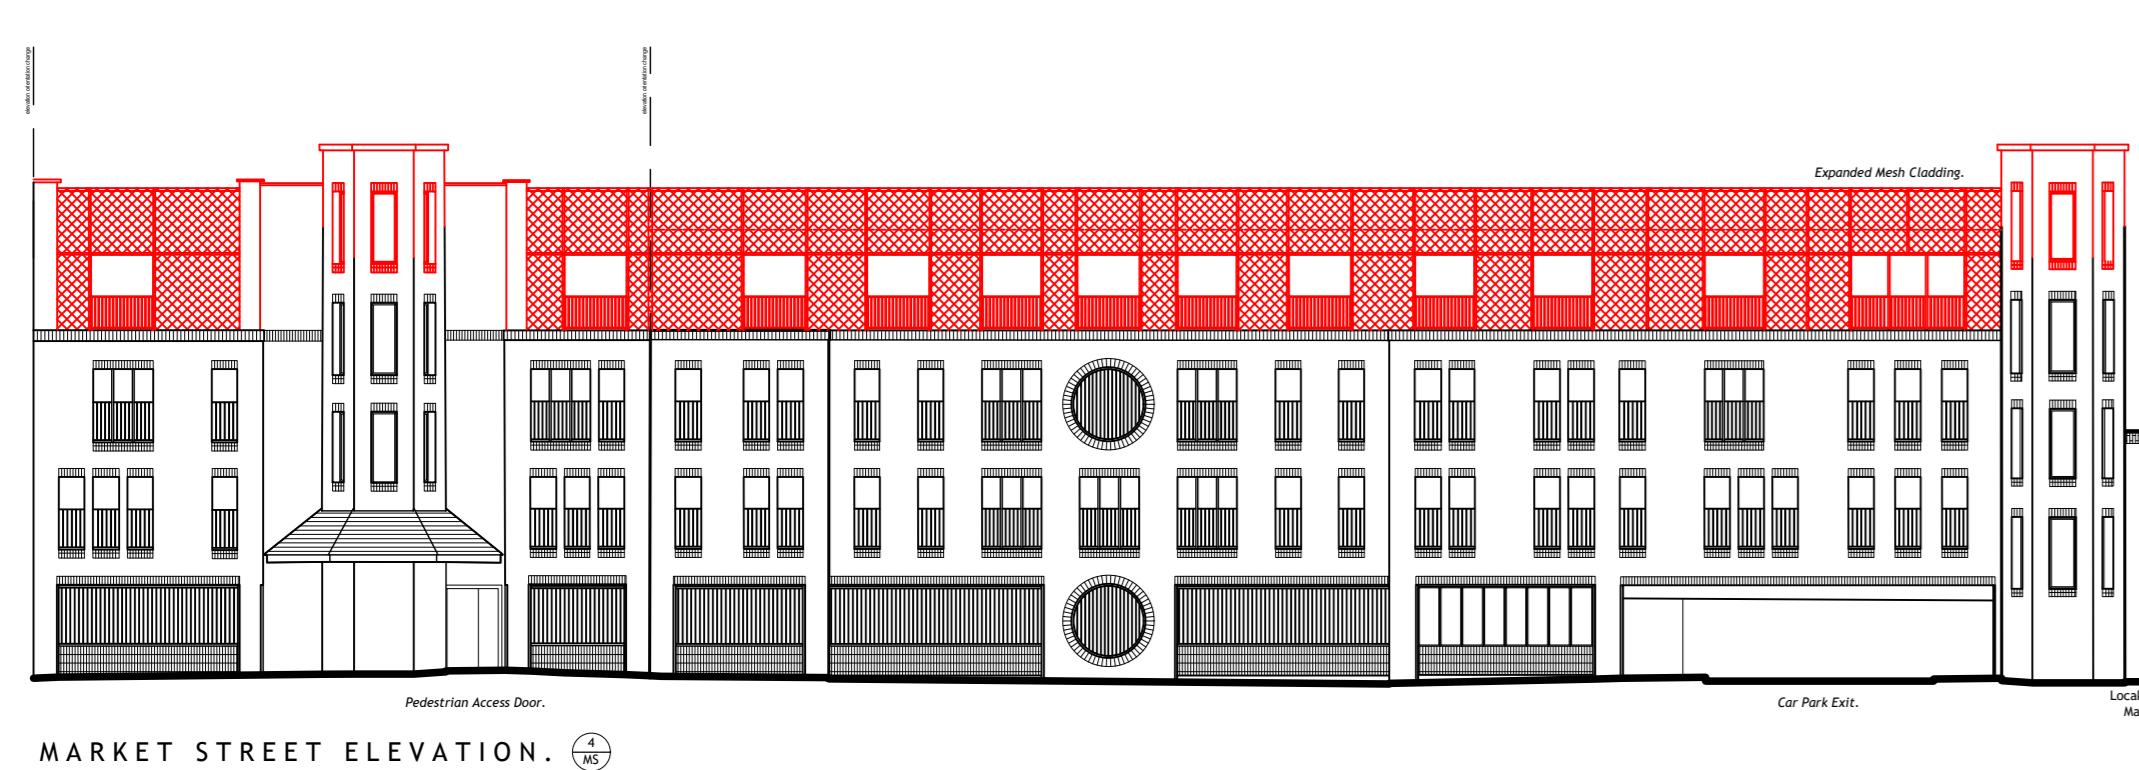

REV	DESCRIPTION	DRN	CHD	DATE
<input checked="" type="checkbox"/>	PRELIMINARY	<input type="checkbox"/>	INFORMATION	<input type="checkbox"/>
<input type="checkbox"/>	CONSTRUCTION	<input type="checkbox"/>	AS BUILT	<input type="checkbox"/>
SCALE	1:200 @ A0	DATE	AUG 2024	
DRAWN	TNM	CHK	JAL	
DRAWING NO.	19401/1045	REV	-	
TITLE	Old Town, Newbury.			
DETAILS	Fourth Floor Plan & Elevations, Multi Storey Car Park.			

**LOCHAILORT**

 Woods Hardwick  
Architecture | Engineering | Planning | Surveying

BEDFORD : HEAD OFFICE  
15-17 Goldington Road  
Bedford MK40 3NH  
T: +44 (0) 1234 268862

BIRMINGHAM  
15-17 Goldington Road  
Bedford MK40 3NH  
T: +44 (0) 1234 268862

ONLINE: mail@woodshardwick.com | woodshardwick.com